



AS BUILT STANCHIONS DSP&P #3 AND #4

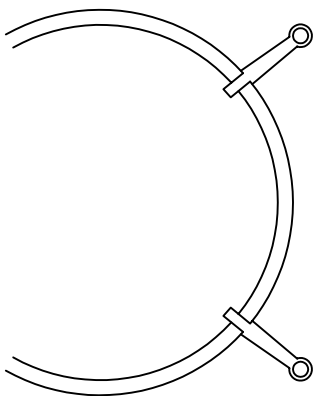

PLAIN STANCHIONS – COMPLETE
4 REQUIRED TO BOILER SIDE

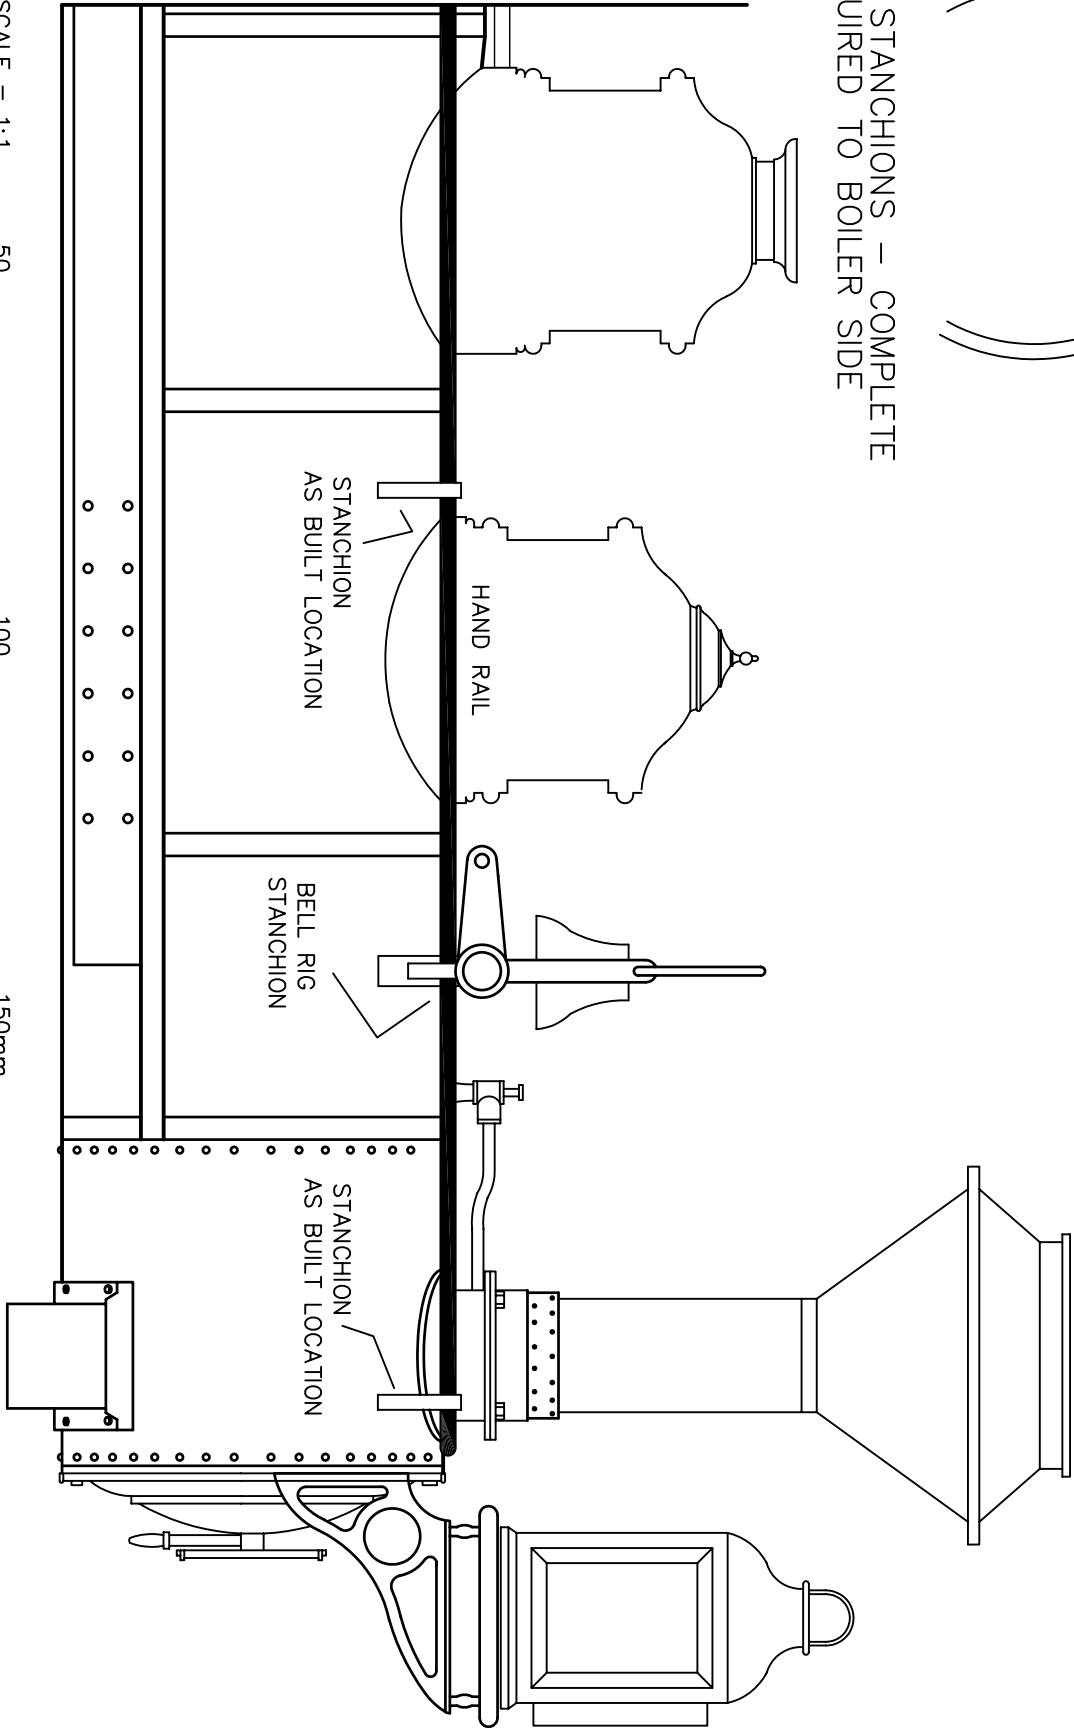

SCALE = 1:1

50

100

150mm

