


TENDER SIDES



TENDER REAR

OVERALL TENDER VIEW
AS-BUILT – LONG TENDER

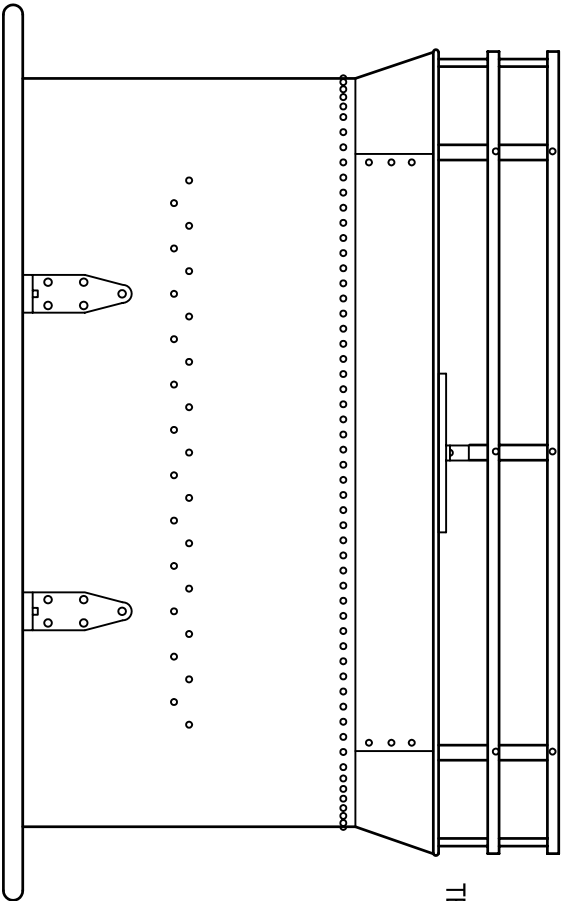